
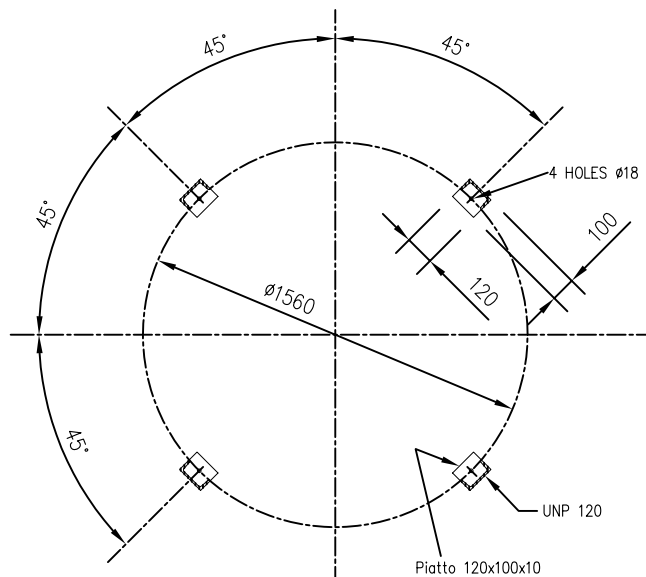


ϕ_f = Drill diameter (16 mm.)
P = Hole depth min. (110 mm.)
 ϕ_v = Screw diameter (M.16x170)
M = Torque (90 Nm.)

FIXING DETAIL
N°4 EXPANSION BOLT M.16
TYPE WURT W-FAZ/S
SUPPLY BY CTM

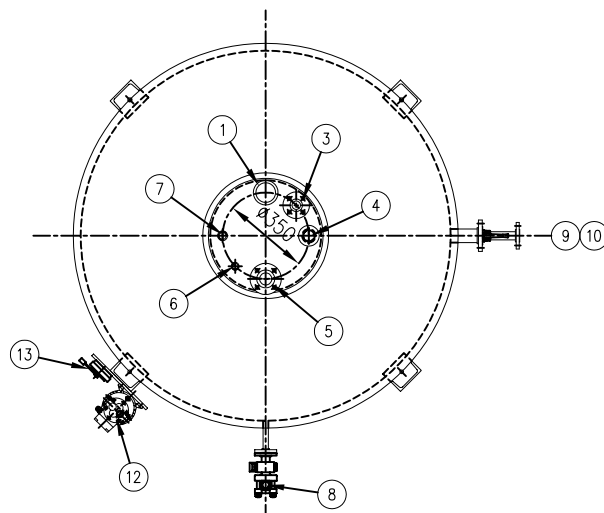

SECTION FERFORATION

**SEIL
AS BUILT**

NAMEPLATE	
CAPACITY:	3500 Litres
EXTERNAL THK:	4 mm.
INTERNAL THK:	5 mm.
MATERIAL:	CARBON STEEL S 235-JR
DRY WEIGHT:	950 Kg.
WET WEIGHT:	3925 Kg.

09			
08			
07			
06			
05			
04			
03			
02	AS BUILT BY SEIL		25/09/12
01	REVISED FUEL TANK	C	22/06/09
00	FIRST ISSUE	I	08/05/09
REV.	REVISION DESCRIPTION AND REFERENCE	ISSUE CAT.	DATE

PREPARED	22/06/09	CT	A.N.	
CHECKED	22/06/09	CT	Zamproni	
AUTHORIZED	22/06/09	CT	Zamproni	

REPLACES DOCUMENT:	MEASURE UNIT	mm	SCALE	1:15	PLOT SCALE	1:1
--------------------	--------------	----	-------	------	------------	-----

endesa chile	ENDESA CHILE ACB - 003.06 BOCAMINA II PROJECT
---------------------	--

Tecnimont SLOVENSKÉ ENERGETICKE STROJARNÉ a.s. TLMAČE	DOUBLE SKIN VERTICAL FUEL TANK 3500 LITRES CAPACITY SUITABLE FOR GROUND INSTALLATION
--	---

DWG IDENTIFIC. NUMBER:	EAD000/A5 (BMA) 500-CT0002 / 02	1	1
------------------------	---------------------------------	---	---

WORK ID	SERIES	KKS ID	KEY PLAN	PROGRESSIVE NUMB.	REV.	SHEET	OF
---------	--------	--------	----------	-------------------	------	-------	----

TOLERANCES EXCEPT WHERE OTHERWISE STATED 0 - 500mm ± 1mm 500-2000mm ± 2mm OVER 2000mm ± 3mm STRUCTURAL ± 3mm ANGULAR ± 0.5 °	compagnia tecnica motori Compagnia Tecnica Motori S.p.A. I-20090 Cassino (Monza e della Brianza) Via Magellano, 1 Telefono 02/430801 (20 linee r.a.) Telefax 02/43080200 - 02/43080202 e-mail: ctm@ctm.it	DRN. BY A.N. DATE 14-01-09 APPD. BY DATE	SHEET SIZE A1 DRAWING N° 6880-S-802	ORIGINAL SCALE 1:15 REV.
DO NOT SCALE	THIS DRAWING AND THE DESIGN SHOWN ARE THE PROPERTY OF C.T.M. S.p.A. AND MUST NOT BE USED OR COPIED WITHOUT THEIR PERMISSION ALL DIMENSIONS IN MILLIMETERS UNLESS OTHERWISE STATED	3rd ANGLE PROJECTION		