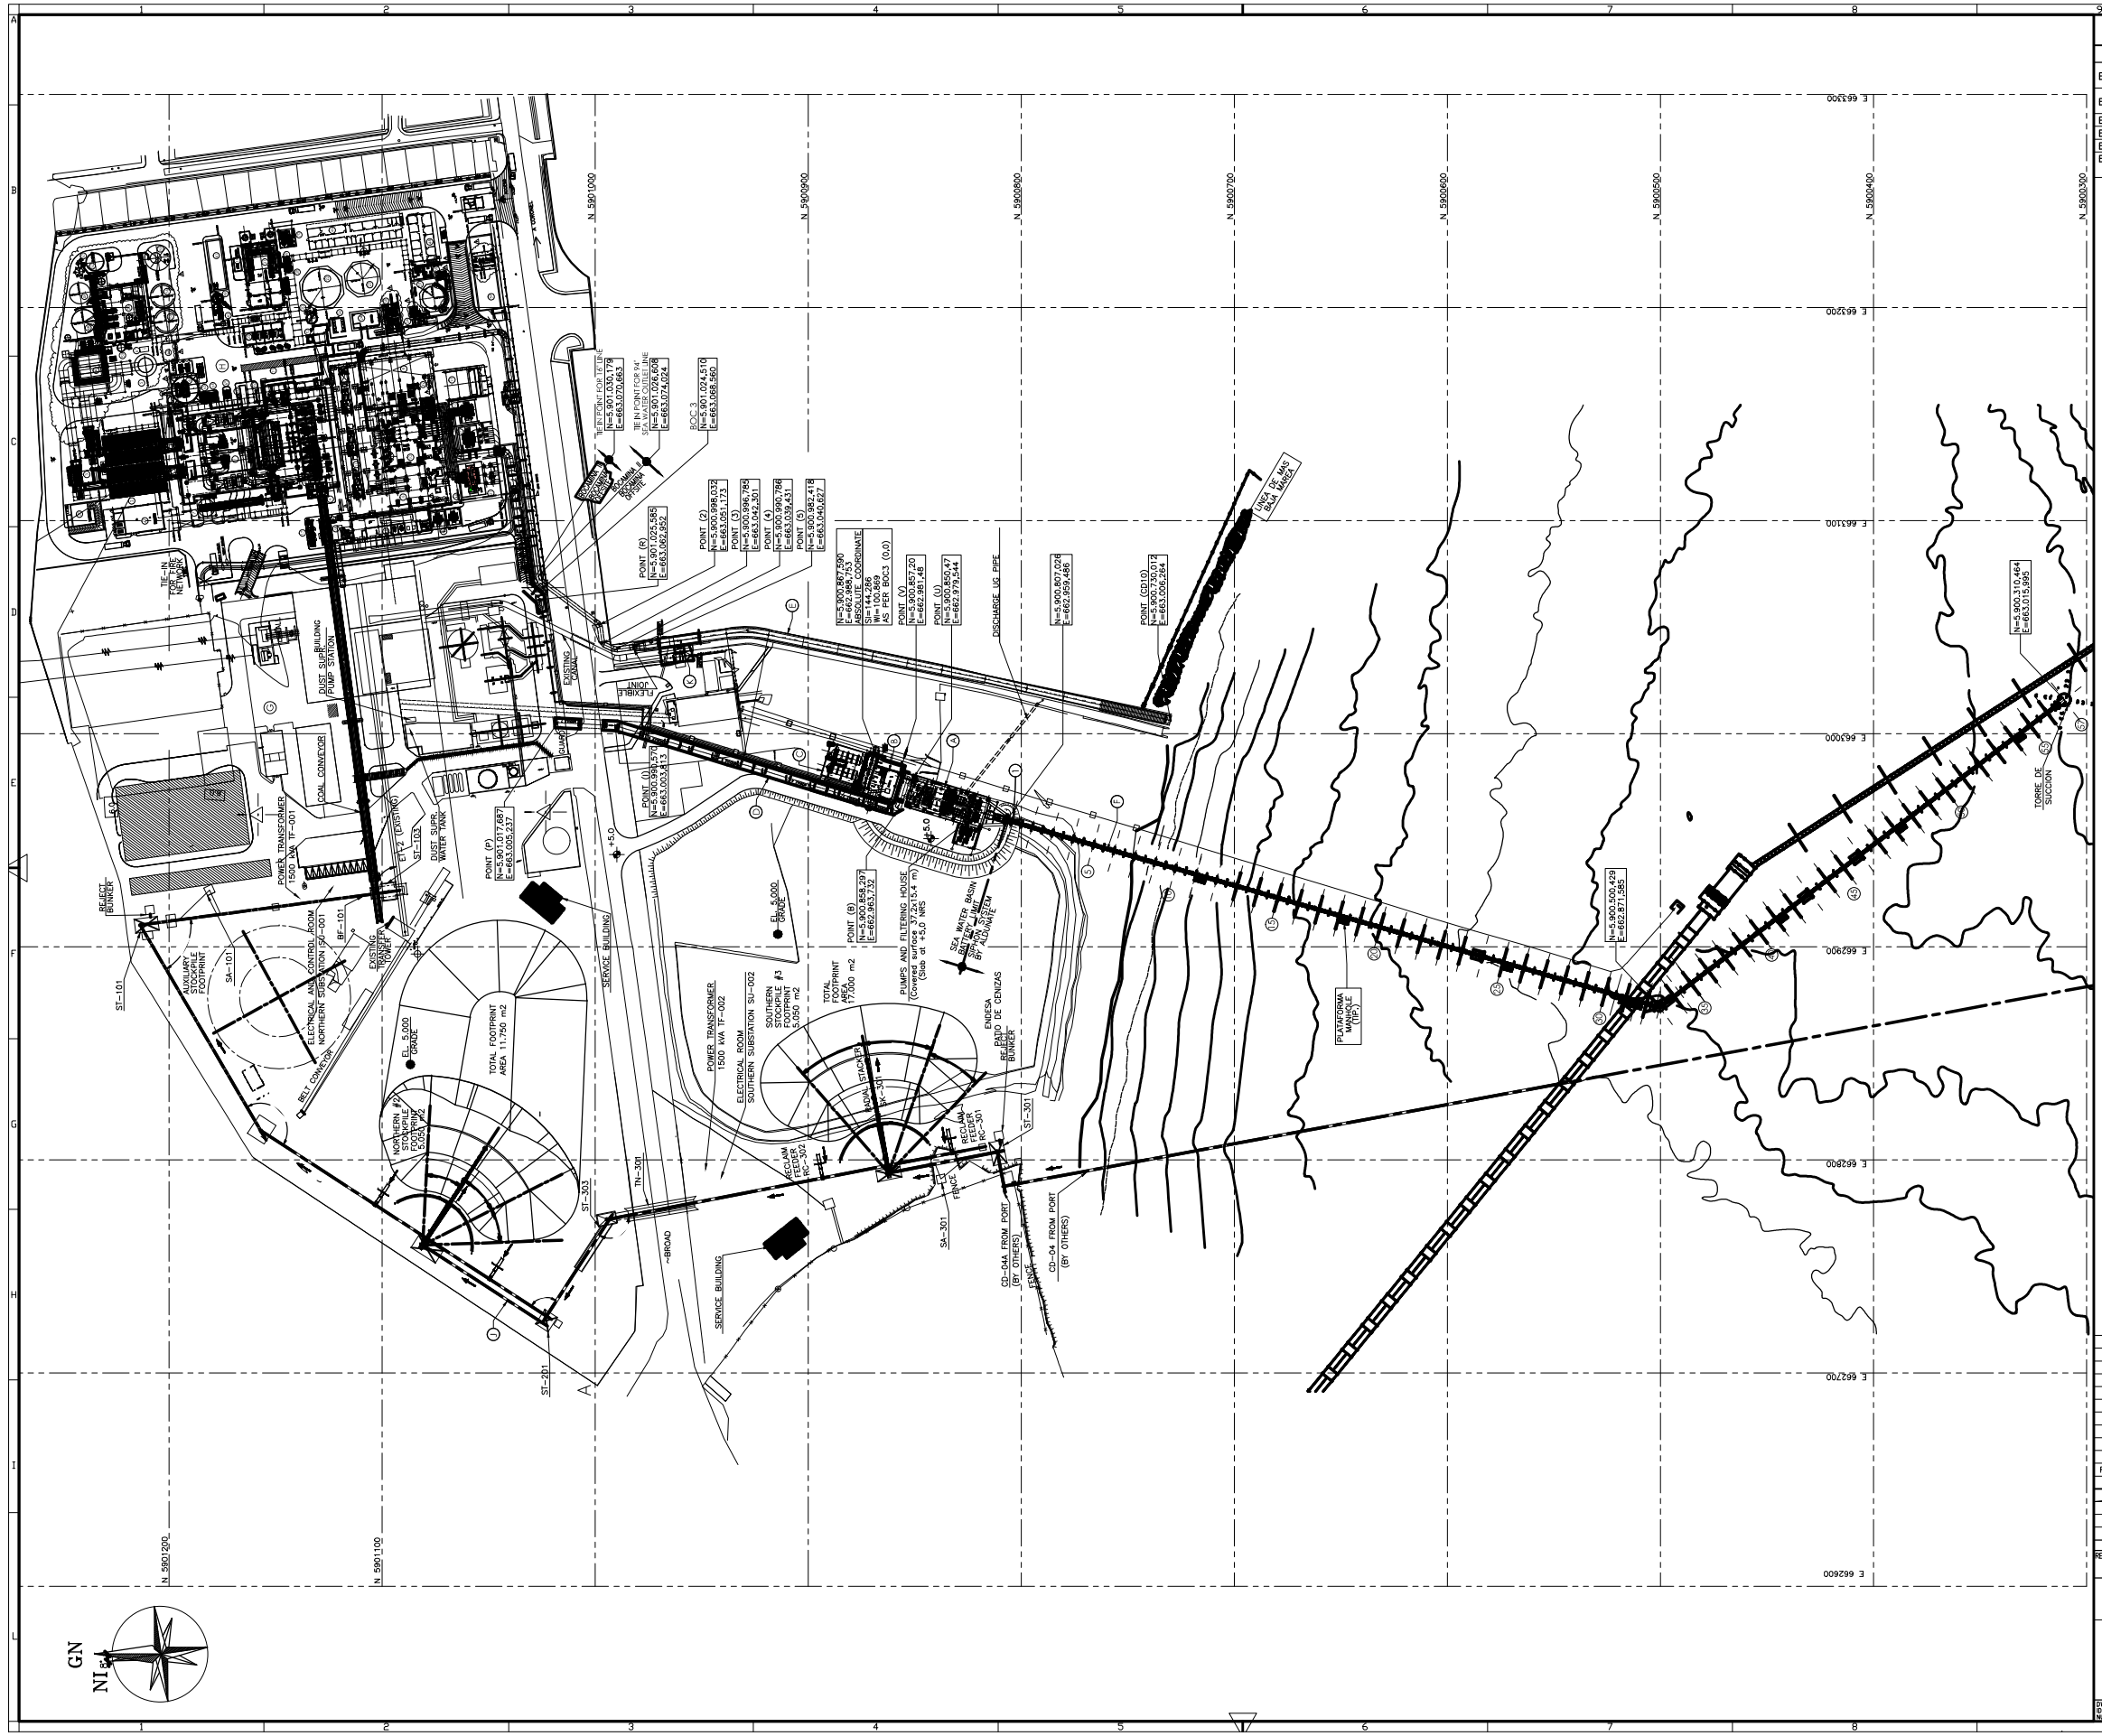

REFERENCE DRAWINGS

NUMBER	TITLE
EA0000/D1-(UXA)-601-32C004	UNDERGROUND SYSTEM GALLERY FOR SEA WATER DELIVERY TO BOCAMINA 1 PLAN CIVIL STRUCTURES
EA0000/E2-(PAA)-600-PW0001	MARINE STRUCTURAL SIPHON GENERAL ARRANGEMENT DETAIL MARINE ENGINEERING
EA0000/D1-(UXA)-600-32C005	SEA WATER INTAKE PUMP HOUSE
EA0000/A1-(UXA)-601-32C001	LINE FROM PUMPS STATION TO BOCAMINA 1
EA0000/G6-(EA*)-100-SM0002	COAL HANDLIG PLANT SITE LAYOUT
EA0000/D1-(UXA)-601-32C020, 32C021,33C022,33C024,33C24	DISCHARGE CHANNEL-BOCAMINA II PLAN CIVIL STRUCTURES

NOTES:
- ALL COORDINATES ARE IN m.

LEGEND

- (A) SEA WATER BASIN / PUMP HOUSE
- (B) ELECTRICAL SUBSTATION
- (C) HYPOCHLORITE AREA
- (D) SEA WATER INTAKE
- (E) SEA WATER DISCHARGE CHANNEL
- (F) SIPHON
- (G) BOCAMINA 4 POWER PLANT
- (H) BOCAMINA 4 POWER PLANT
- (I) COAL HANDLING PLANT
- (K) SAMPLING SYSTEM

AS BUILT

NOTES:

POINT 0,0,0 OF POWER PLANT (BOC 3) CORRESPONDS TO:
E=663,068.56
N=5,901,024.51
EL. = +6,22 N.R.S.

REV.	REVISION DESCRIPTION AND REFERENCE	ISSUE CAT.	DATE
09			
08			
07			
06			
05			
04			
03			
02			
01	ISSUED FOR CONSTRUCTION	C	08/06/10
00	ISSUED FOR INFORMATION	I	25/09/09

	DATE	UNIT	INITIAL/NAME	SIGNATURE
PREPARED	08/06/10	CLN-L330	TICB	
CHECKED	08/06/10	CLN-L330	MELZI	
AUTHORIZED	08/06/10	CLN-L330	RINOLDIR	

REPLACES DOCUMENT:

MEASURE UNIT mm | SCALE 1:1000 | PLOT SCALE 1:1

endesa chile

ENDESA CHILE
ACB - 003.06
BOCAMINA II PROJECT

BOCAMINA POWER PLANT
ENLARGEMENT PROJECT – SECOND UNIT
OVERALL GENERAL LAYOUT

DRG IDENTIFIC NUMBER: EA0000 F3 (VVY) 000 33M005 01 | 1 | 1

WORK Id | SERIES | KKS Id | KEY PLAN | PROGRESSIVE NUMB. | REV. | SHEET | OF